


二画整理事業

画地出来形確認測量原図

縮尺 1 : 500

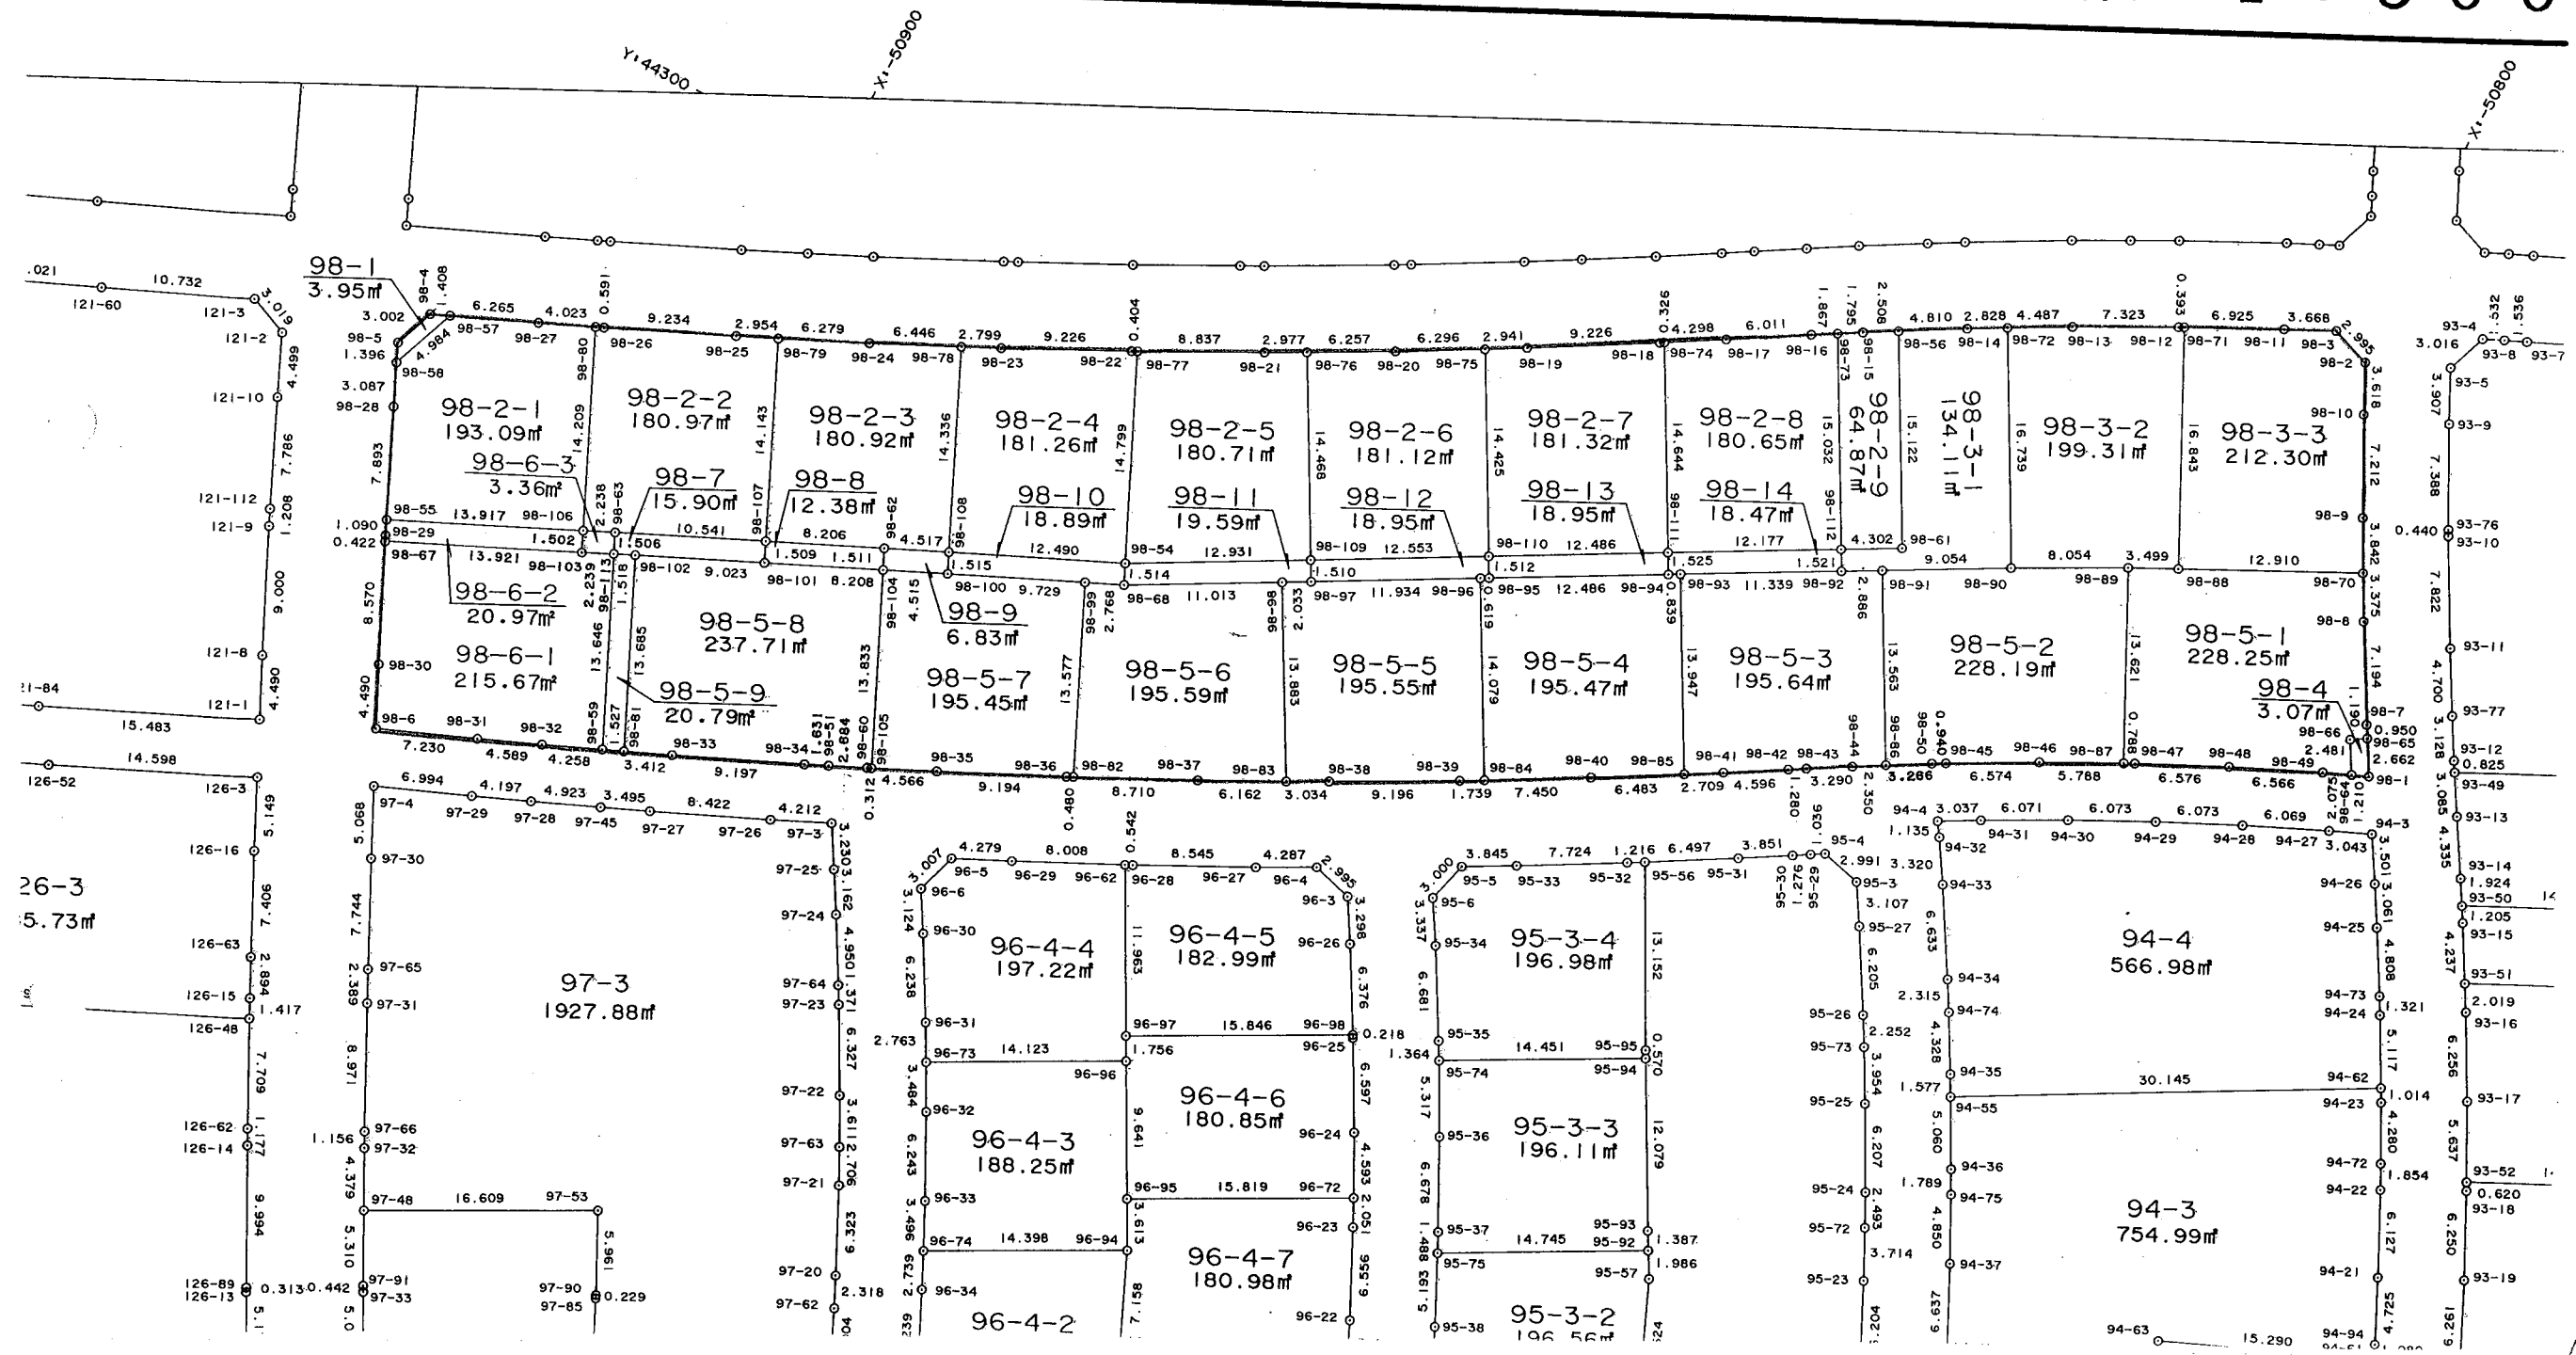

* * 面積計算 (座標法) * *

地 器 械 点	番 号 視 準 点	98-1 内 角	方 向 角	距 離	[1] X(i)	[2] Y(i)	[3] X(i+1)-X(i-1)	[2]*[3]
98-4	98-5	134-48-36	111-20-56	3.002	-50920.254	44322.484	-2.384	-105664.801856
98-5	98-58	135-10-37	66-31-33	1.396	-50921.346	44325.279	-0.536	-23758.349544
98-58	98-57	44-59-41	291-31-14	4.984	-50920.790	44326.559	2.384	105674.516656
98-57	98-4	45-01-06	156-32-20	1.408	-50918.962	44321.923	0.536	23756.550728
							倍 面 積	7.915984
							面 積	3.9579920
							坪 数	1.19

* * 面積計算（座標法） * *

[illegible]

* * 面積計算 (座標法) * *

地 器 械 点	番 ： 視 準 点	98-6-2 內 角	方 向 角	距 離	[1] X(i)	[2] Y(i)	[3] X(i+1)-X(i-1)	[2]*[3]
98-55	98-29	90-13-45	65-45-12	1.090	-50916.291	44336.575	-12.219	-541748.609925
98-29	98-67	179-46-50	65-32-02	0.422	-50915.843	44337.569	0.623	27622.305487
98-67	98-103	89-56-45	335-28-47	13.921	-50915.668	44337.953	12.840	569299.316520
98-103	98-106	90-04-25	245-33-12	1.502	-50903.003	44332.176	12.044	533936.727744
98-106	98-55	89-58-15	155-31-27	13.917	-50903.624	44330.809	-13.288	-589067.789992
							倍 面 積	41.949834
							面 積	20.9749170
							坪 數	6.34

* * 面積計算 (座標法) * *

[illegible]

* * 面積計算 (座標法) * *

[illegible]

* * 面積計算 (座標法) * *

地 器 械 点	番 号 視 準 点	98-9 内 角	方 向 角	距 離	[1] X(i)	[2] Y(i)	[3] X(i+1)-X(i-1)	[2]*[3]
98-100	98-108	89-58-44	245-33-07	1.515	-50879.787	44321.622	3.484	154416.531048
98-108	98-62	89-58-20	155-31-27	4.517	-50880.414	44320.243	-4.738	-209989.311334
98-62	98-104	89-56-51	65-28-18	1.511	-50884.525	44322.115	-3.484	-154418.248660
98-104	98-100	90-06-05	335-34-23	4.515	-50883.898	44323.489	4.738	210004.690882
							倍 面 積	13.661936
							面 積	6.8309680
							坪 数	2.06

* * 面積計算 (座標法) * *

[illegible]

* * 面積計算 (座標法) * *

地 器 械 点	番 視 準 点	98-10 内 角	方 向 角	距 離	[1] X(i)	[2] Y(i)	[3] X(i+1)-X(i-1)	[2]*[3]
98-68	98-54	89-41-59	245-16-55	1.514	-50868.413	44316.444	1.888	83669.446272
98-54	98-108	90-14-32	155-31-27	12.490	-50869.046	44315.069	-12.001	-531825.143069
98-108	98-100	90-01-40	65-33-07	1.515	-50880.414	44320.243	-10.741	-476043.730063
98-100	98-99	89-57-05	335-30-12	9.729	-50879.787	44321.622	9.480	420168.976560
98-99	98-68	180-04-44	335-34-56	2.768	-50870.934	44317.588	11.374	504068.245912
							倍 面 積	37.795612
							面 積	18.8978060
							坪 数	5.71

* * 面積計算 (座標法) * *

地 器 械 点	番 号 : 視 準 点	98-2-5 内 角	方 向 角	距 離	[1] X(i)	[2] Y(i)	[3] X(i+1)-X(i-1)	[2]*[3]
98-77	98-54	92-49-28	65-16-55	14.799	-50875.234	44301.626	-1.647	-72964.778022
98-54	98-109	85-38-08	330-55-03	12.931	-50869.046	44315.069	17.489	775026.241741
98-109	98-76	90-01-07	240-56-10	14.468	-50857.745	44308.783	4.273	189331.429759
98-76	98-21	90-57-19	151-53-29	2.977	-50864.773	44296.137	-9.654	-427634.906598
98-21	98-77	180-33-58	152-27-27	8.837	-50867.399	44297.540	-10.461	-463396.565940
							倍 面 積	361.420940
							面 積	180.7104700
							坪 数	54.66

* * 面積計算 (座標法) * *

[illegible]

* * 面積計算 (座標法) * *

[illegible]

* * 面積計算（座標法） * *

地 器 械 点	番 視 準 点	98-12 内 角	方 向 角	距 離	[1] X(i)	[2] Y(i)	[3] X(i+1)-X(i-1)	[2]*[3]
98-95	98-110	89-46-22	240-55-53	1.512	-50846.040	44304.003	-0.192	-8506.368576
98-110	98-109	89-59-10	150-55-03	12.553	-50846.774	44302.681	-11.705	-518562.881105
98-109	98-97	90-01-07	60-56-10	1.510	-50857.745	44308.783	-10.238	-453633.320354
98-97	98-96	89-58-42	330-54-52	11.934	-50857.012	44310.103	11.163	494633.679789
98-96	98-95	180-14-39	331-09-31	0.619	-50846.582	44304.301	10.972	486106.790572
							倍 面 積	37.900326
							面 積	18.9501630
							坪 数	5.73

* * 面積計算 (座標法) * *

地 器 械 点	番 号 : 視 準 点	98-2-7 内 角	方 向 角	距 離	[1] X(i)	[2] Y(i)	[3] X(i+1)-X(i-1)	[2]*[3]
98-75	98-110	90-31-13	60-55-53	14.425	-50853.783	44290.073	4.451	197135.114923
98-110	98-111	89-59-10	330-55-03	12.486	-50846.774	44302.681	17.921	793948.346201
98-111	98-74	90-01-58	240-57-01	14.644	-50835.862	44296.612	3.801	168371.422212
98-74	98-18	87-34-05	148-31-06	0.326	-50842.973	44283.810	-7.389	-327213.072090
98-18	98-19	181-16-59	149-48-05	9.226	-50843.251	44283.980	-8.252	-365431.402960
98-19	98-75	180-36-35	150-24-40	2.941	-50851.225	44288.621	-10.532	-466447.756372
							倍 面 積	362.651914
							面 積	181.3259570
							坪 数	54.85

* * 面積計算 (座標法) * *

地 器 械 点	番 視 準 点	98-2-8						
		内 角	方 向 角	距 離	[1]	[2]	[3]	[2]*[3]
					X(i)	Y(i)	X(i+1)-X(i-1)	
98-74	98-111	91-46-54	60-57-01	14.644	-50842.973	44283.810	3.420	151450.630200
98-111	98-112	89-58-02	330-55-03	12.177	-50835.862	44296.612	17.753	786397.752836
98-112	98-73	90-00-24	240-55-27	15.032	-50825.220	44290.693	3.337	147798.042541
98-73	98-16	88-28-55	149-24-22	1.867	-50832.525	44277.555	-8.913	-394645.847715
98-16	98-17	179-32-07	148-56-29	6.011	-50834.133	44278.506	-6.757	-299189.865042
98-17	98-74	180-13-38	149-10-07	4.298	-50839.282	44281.607	-8.840	-391449.405880
							倍 面 積	361.306940
							面 積	180.6534700
							坪 数	54.64

* * 面積計算 (座標法) * *

地 器 械 点	番 視 準 点	98-14 内 角	方 向 角	距 離	[1] X(i)	[2] Y(i)	[3] X(i+1)-X(i-1)	[2]*[3]
98-92	98-112	89-58-18	240-55-27	1.521	-50824.481	44292.022	9.174	406335.009828
98-112	98-111	89-59-36	150-55-03	12.177	-50825.220	44290.693	-11.381	-504072.377033
98-111	98-94	90-01-58	60-57-01	1.525	-50835.862	44296.612	-9.902	-438625.052024
98-94	98-93	89-11-26	330-08-27	0.839	-50835.122	44297.945	1.468	65029.383260
98-93	98-92	180-48-42	330-57-09	11.339	-50834.394	44297.527	10.641	471369.984807
							倍 面 積	36.948838
							面 積	18.4744190
							坪 数	5.58

* * 面積計算 (座標法) * *

地 器 械 点	番 号 視 準 点	98-2-9 内 角	方 向 角	距 離	[1] X(i)	[2] Y(i)	[3] X(i+1)-X(i-1)	[2]*[3]
98-73	98-112	91-25-02	60-55-27	15.032	-50832.525	44277.555	5.758	254950.161690
98-112	98-61	89-59-36	330-55-03	4.302	-50825.220	44290.693	11.064	490032.227352
98-61	98-56	90-00-31	240-55-34	15.122	-50821.461	44288.602	-3.589	-158951.792578
98-56	98-15	88-56-31	149-52-05	2.508	-50828.809	44275.385	-9.517	-421368.839045
98-15	98-73	179-38-20	149-30-25	1.795	-50830.978	44276.644	-3.716	-164532.009104
							倍 面 積	129.748315
							面 積	64.8741575
							坪 数	19.62

* * 面積計算 (座標法) * *

地 器 械 点	番 ： 視 準 点	98-3-1 内 角	方 向 角	距 離	[1]	[2]	[3]	[2]*[3]
					X(i)	Y(i)	X(i+1)-X(i-1)	
98-90	98-72	90-00-18	240-55-25	16.739	-50814.047	44286.217	-0.222	-9831.540174
98-72	98-14	89-48-07	150-43-32	2.828	-50822.182	44271.588	-10.602	-469367.375976
98-14	98-56	179-08-33	149-52-05	4.810	-50824.649	44272.971	-6.627	-293396.978817
98-56	98-61	91-03-29	60-55-34	15.122	-50828.809	44275.385	3.188	141149.927380
98-61	98-112	269-59-29	150-55-03	4.302	-50821.461	44288.602	3.589	158951.792578
98-112	98-92	90-00-24	60-55-27	1.521	-50825.220	44290.693	-3.020	-133757.892860
98-92	98-91	89-57-52	330-53-19	2.886	-50824.481	44292.022	3.260	144391.991720
98-91	98-90	180-01-48	330-55-07	9.054	-50821.960	44290.618	10.434	462128.308212
							倍 面 積	268.232063
							面 積	134.1160315
							坪 数	40.57

* * 面積計算 (座標法) * *

地 器 械 点	番 ： 視 準 点	98-3-2						
		内 角	方 向 角	距 離	[1]	[2]	[3]	[2]*[3]
					X(i)	Y(i)	X(i+1)-X(i-1)	
98-88	98-71	89-50-07	243-08-42	16.843	-50803.820	44280.846	-4.482	-198466.751772
98-71	98-12	89-13-30	152-22-12	0.393	-50811.428	44265.820	-7.956	-352178.863920
98-12	98-13	179-44-43	152-06-55	7.323	-50811.776	44266.002	-6.821	-301938.399642
98-13	98-72	179-06-22	151-13-17	4.487	-50818.249	44269.427	-10.406	-460667.657362
98-72	98-90	89-42-08	60-55-25	16.739	-50822.182	44271.588	4.202	186029.212776
98-90	98-89	90-55-55	331-51-20	8.054	-50814.047	44286.217	15.236	674744.802212
98-89	98-88	181-27-15	333-18-35	3.499	-50806.946	44282.418	10.227	452876.288886
							倍 面 積	398.631178
							面 積	199.3155890
							坪 数	60.29

* * 面積計算 (座標法) * *

[illegible]

* * 面積計算 (座標法) * *

地 器 械 点	番 視 準 点	98-5-1 内 角	方 向 角	距 離	[1]	[2]	[3]	[2]*[3]
					X(i)	Y(i)	X(i+1)-X(i-1)	
98-64	98-66	82-49-46	239-30-41	2.481	-50786.333	44287.769	0.646	28609.898774
98-66	98-65	268-26-03	327-56-44	1.190	-50787.592	44285.631	-0.250	-11071.407750
98-65	98-7	91-00-33	238-57-17	0.950	-50786.583	44285.000	0.519	22983.915000
98-7	98-8	181-06-42	240-03-59	7.194	-50787.073	44284.186	-4.080	-180679.478880
98-8	98-70	180-46-20	240-50-19	3.375	-50790.663	44277.952	-5.234	-231750.800768
98-70	98-88	92-15-22	153-05-41	12.910	-50792.307	44275.005	-13.157	-582526.240785
98-88	98-89	180-12-54	153-18-35	3.499	-50803.820	44280.846	-14.639	-648227.304594
98-89	98-87	89-56-10	63-14-45	13.621	-50806.946	44282.418	3.006	133112.948508
98-87	98-47	90-38-54	333-53-39	0.788	-50800.814	44294.581	6.840	302974.934040
98-47	98-48	180-00-46	333-54-25	6.576	-50800.106	44294.234	6.614	292962.063676
98-48	98-49	181-19-04	335-13-29	6.566	-50794.200	44291.342	11.868	525649.646856
98-49	98-64	181-27-26	336-40-55	2.075	-50788.238	44288.590	7.867	348418.337530
倍 面 積								456.511607
面 積								228.2558035
坪 数								69.04

* * 面積計算 (座標法) * *

地 器 械 点	番 号 視 準 点	98-5-2 内 角	方 向 角	距 離	[1] X(i)	[2] Y(i)	[3] X(i+1)-X(i-1)	[2]*[3]
98-87	98-89	90-37-07	243-14-45	13.621	-50800.814	44294.581	-0.992	-43940.224352
98-89	98-90	88-36-35	151-51-20	8.054	-50806.946	44282.418	-13.233	-585989.237394
98-90	98-91	179-03-47	150-55-07	9.054	-50814.047	44286.217	-15.014	-664913.262038
98-91	98-86	90-02-57	60-58-04	13.563	-50821.960	44290.618	-1.331	-58950.812558
98-86	98-50	89-17-17	330-15-21	3.266	-50815.378	44302.476	9.418	417240.718968
98-50	98-45	180-00-00	330-15-21	0.940	-50812.542	44300.856	3.652	161786.726112
98-45	98-46	181-08-27	331-23-48	6.574	-50811.726	44300.390	6.588	291850.969320
98-46	98-87	181-13-50	332-37-38	5.788	-50805.954	44297.242	10.912	483371.504704
							倍 面 積	456.382762
							面 積	228.1913810
							坪 数	69.02

* * 面積計算 (座標法) * *

[illegible]

* * 面積計算 (座標法) * *

地 器 械 点	番 ： 視 準 点	98-5-4						
		内 角	方 向 角	距 離	[1]	[2]	[3]	[2]*[3]
					X(i)	Y(i)	X(i+1)-X(i-1)	
98-85	98-93	90-51-49	240-57-00	13.947	-50827.621	44309.720	-1.153	-51089.107160
98-93	98-94	89-11-27	150-08-27	0.839	-50834.394	44297.527	-7.501	-332275.750027
98-94	98-95	180-50-15	150-58-42	12.486	-50835.122	44297.945	-11.646	-515893.867470
98-95	98-96	180-10-49	151-09-31	0.619	-50846.040	44304.003	-11.460	-507723.874380
98-96	98-84	89-44-34	60-54-05	14.079	-50846.582	44304.301	6.304	279294.313504
98-84	98-40	89-45-45	330-39-50	7.450	-50839.736	44316.603	13.341	591227.800623
98-40	98-85	179-25-21	330-05-11	6.483	-50833.241	44312.953	12.115	536851.425595
							倍 面 積	390.940685
							面 積	195.4703425
							坪 数	59.12

* * 面積計算 (座標法) * *

[illegible]

* * 面積計算 (座標法) * *

[illegible]

* * 面積計算 (座標法) * *

[illegible]

<< 大綱 緑ヶ丘土地区画整理（確定） 4/4 >>

* * 面積計算（座標法） * *

[illegible]